

BRUHAT BANGALORE MAHANAGARA PALIKE

Improvements to widen portion of roads,construction of New drains UG Cable ducts and Footpath at Doddabommasandra main road and surroumding Roads in ward no 10

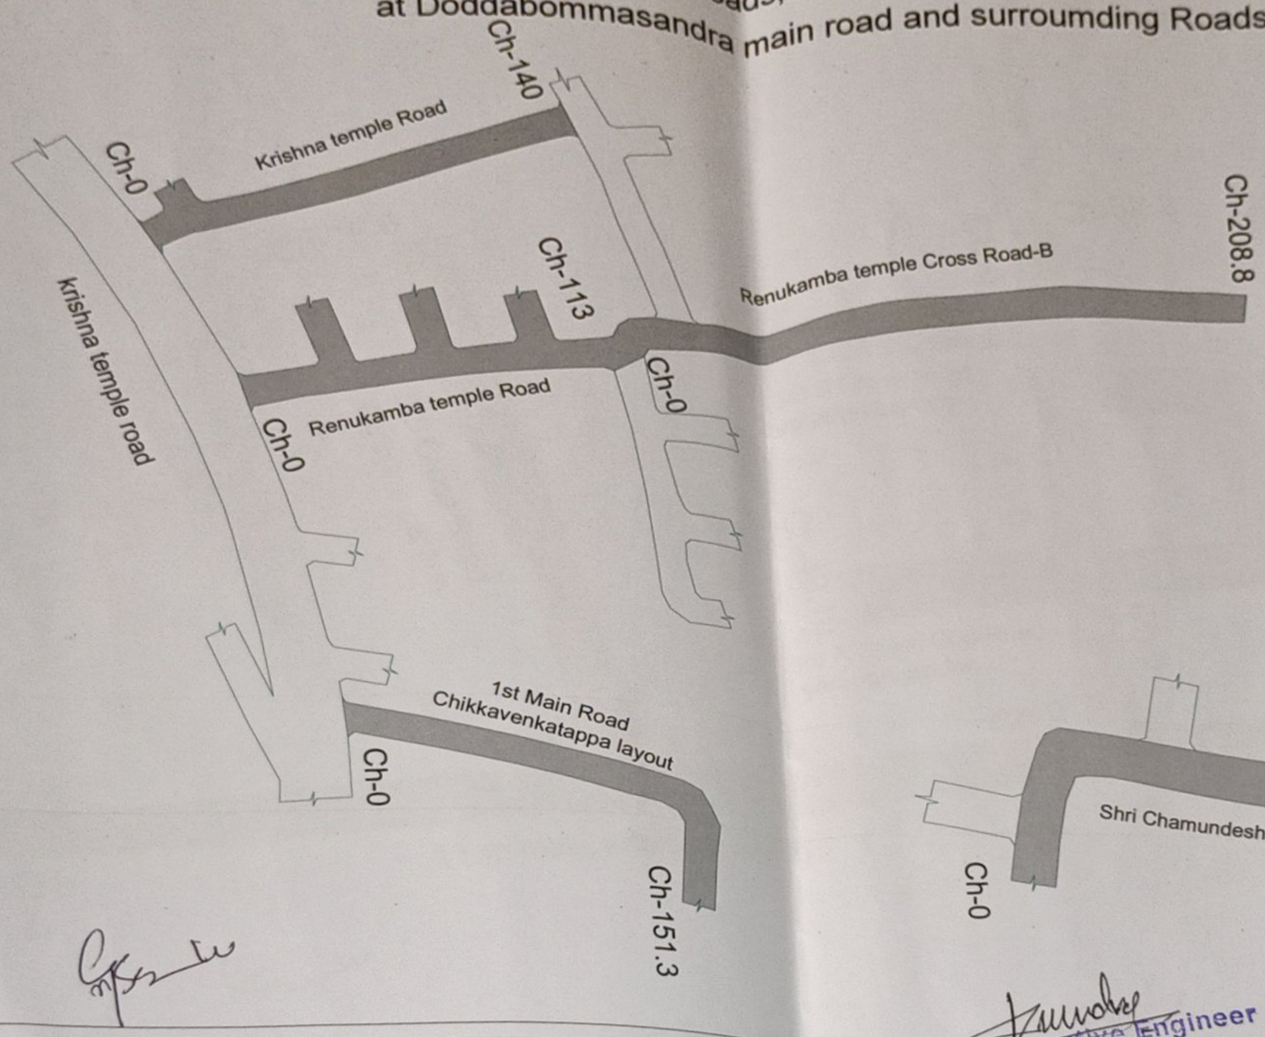

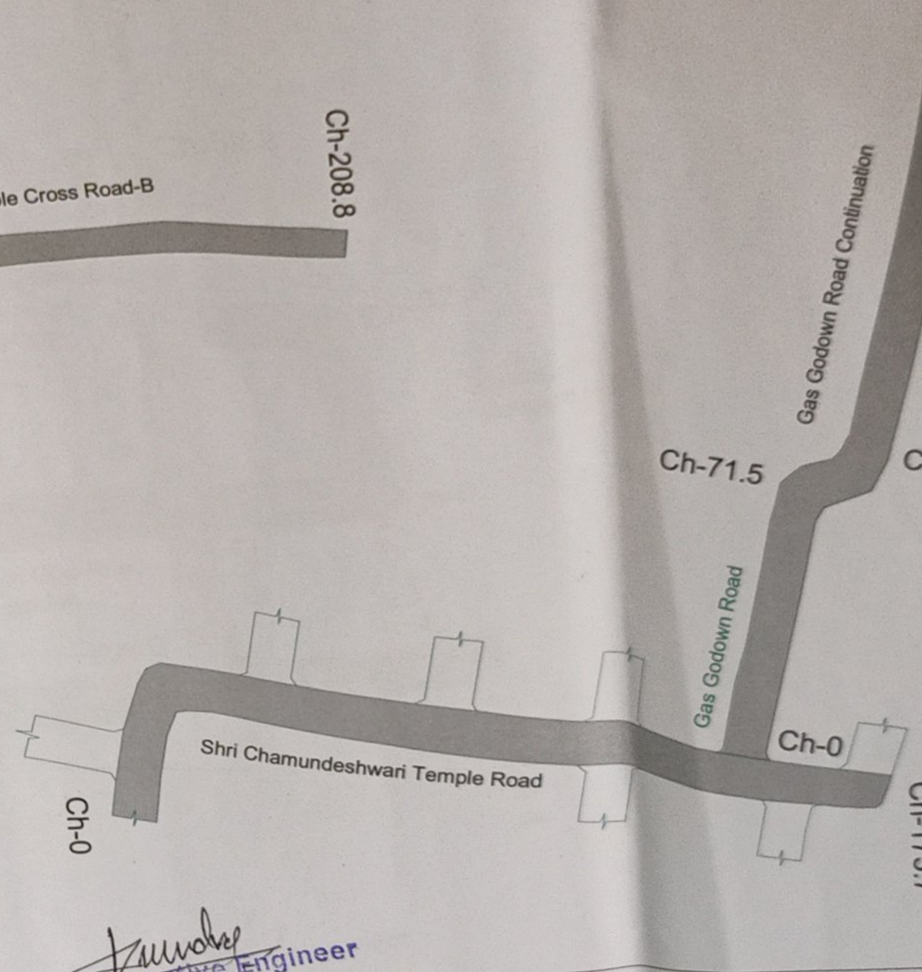

NOTE:-

1. ALL DIMENSION & LEVELS ARE Mts. UNLESS OTHERWISE MENTIONED.

DATE	No. OF PRINTS	PRINTS ISSUED TO	SIGN

DATE	REVISION	DESCRIPTIONS	SIGN

LEGEND

ASPHALTED SURFACE

Asst. Executive Engineer
Project Division
Yelahanka Zone
BBMP, Bangalore - 92

CONSULTANT:

TEJUS CONSULTANTS
CONSULTING ENGINEERS AND DESIGNERS
No.45,Present BBMP No.1204/45,
Old No.1204,1st Main MRCR Layout ,Bangalore-560040
TEL:9611644110,9611192254
email: tejusconsultants@gmail.com


TITLE:

AS BUILT DRAWING 1/1

Scanned by TapScanner

BRUHAT BANGALORE MAHANAGARA PALIKE

Improvements to widen portion of roads,construction of New drains UG Cable ducts and Footpath at Doddabommasandra main road and surroumding Roads in ward no 10

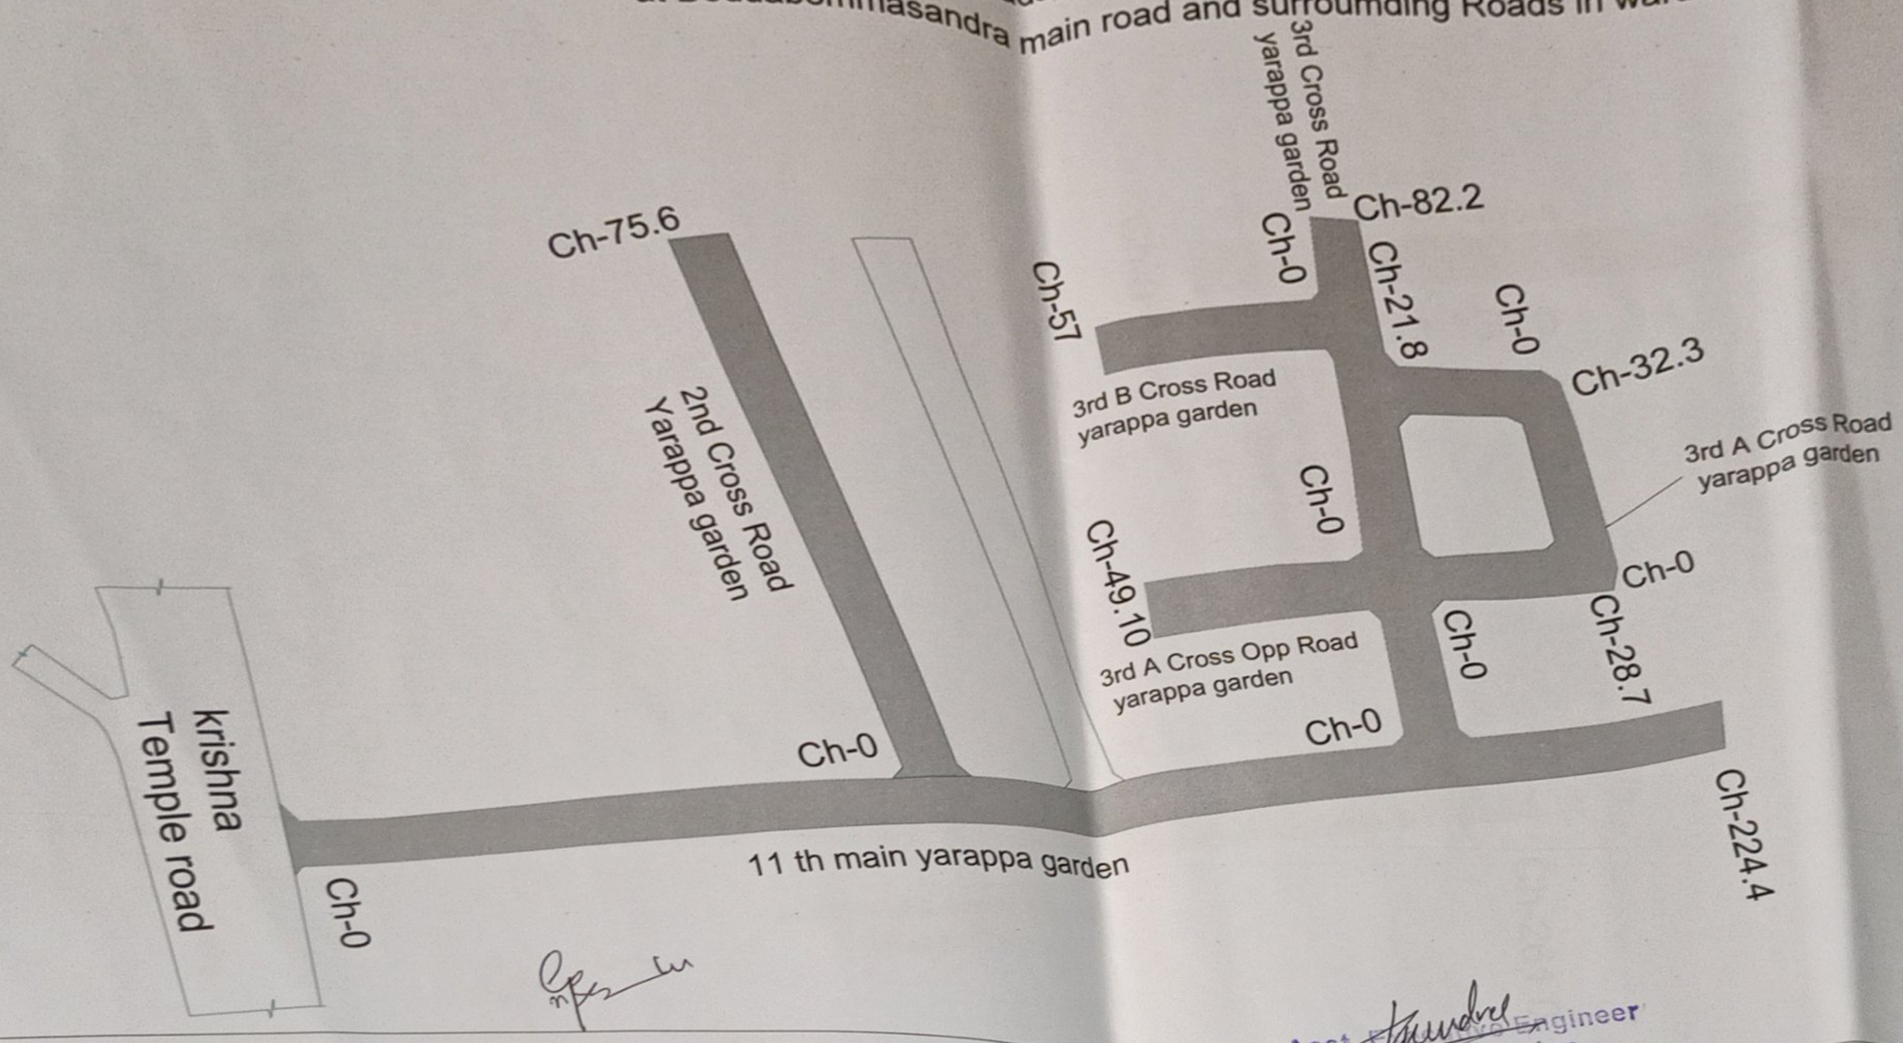

NOTE:-

1. ALL DIMENSION & LEVELS ARE Mts. UNLESS OTHERWISE MENTIONED.

DATE	No. OF PRINTS	PRINTS ISSUED TO	SIGN

DATE	REVISION	DESCRIPTIONS	SIGN

LEGEND:-

ASPHALTED SURFACE

Asst. Executive Engineer
Project Division
Yelahanka Zone
BBMP, Bangalore - 92

CONSULTANT :


TEJUS CONSULTANTS
CONSULTING ENGINEERS AND DESIGNERS
No.45,Present BBMP No.1204/45,
Old No.1204,1st Main MACK Layout ,Bangalore-560040
TEL:9611644110,9611192254
email: tejusconsultants@gmail.com

TITLE: AS BUILT DRAWING 1/1

Scanned by TapScanner

BRUHAT BANGALORE MAHANAGARA PALIKE

Improvements to widen portion of roads,construction of New drains UG Cable ducts and Footpath at Doddabommasandra main road and surroumding Roads in ward no 10

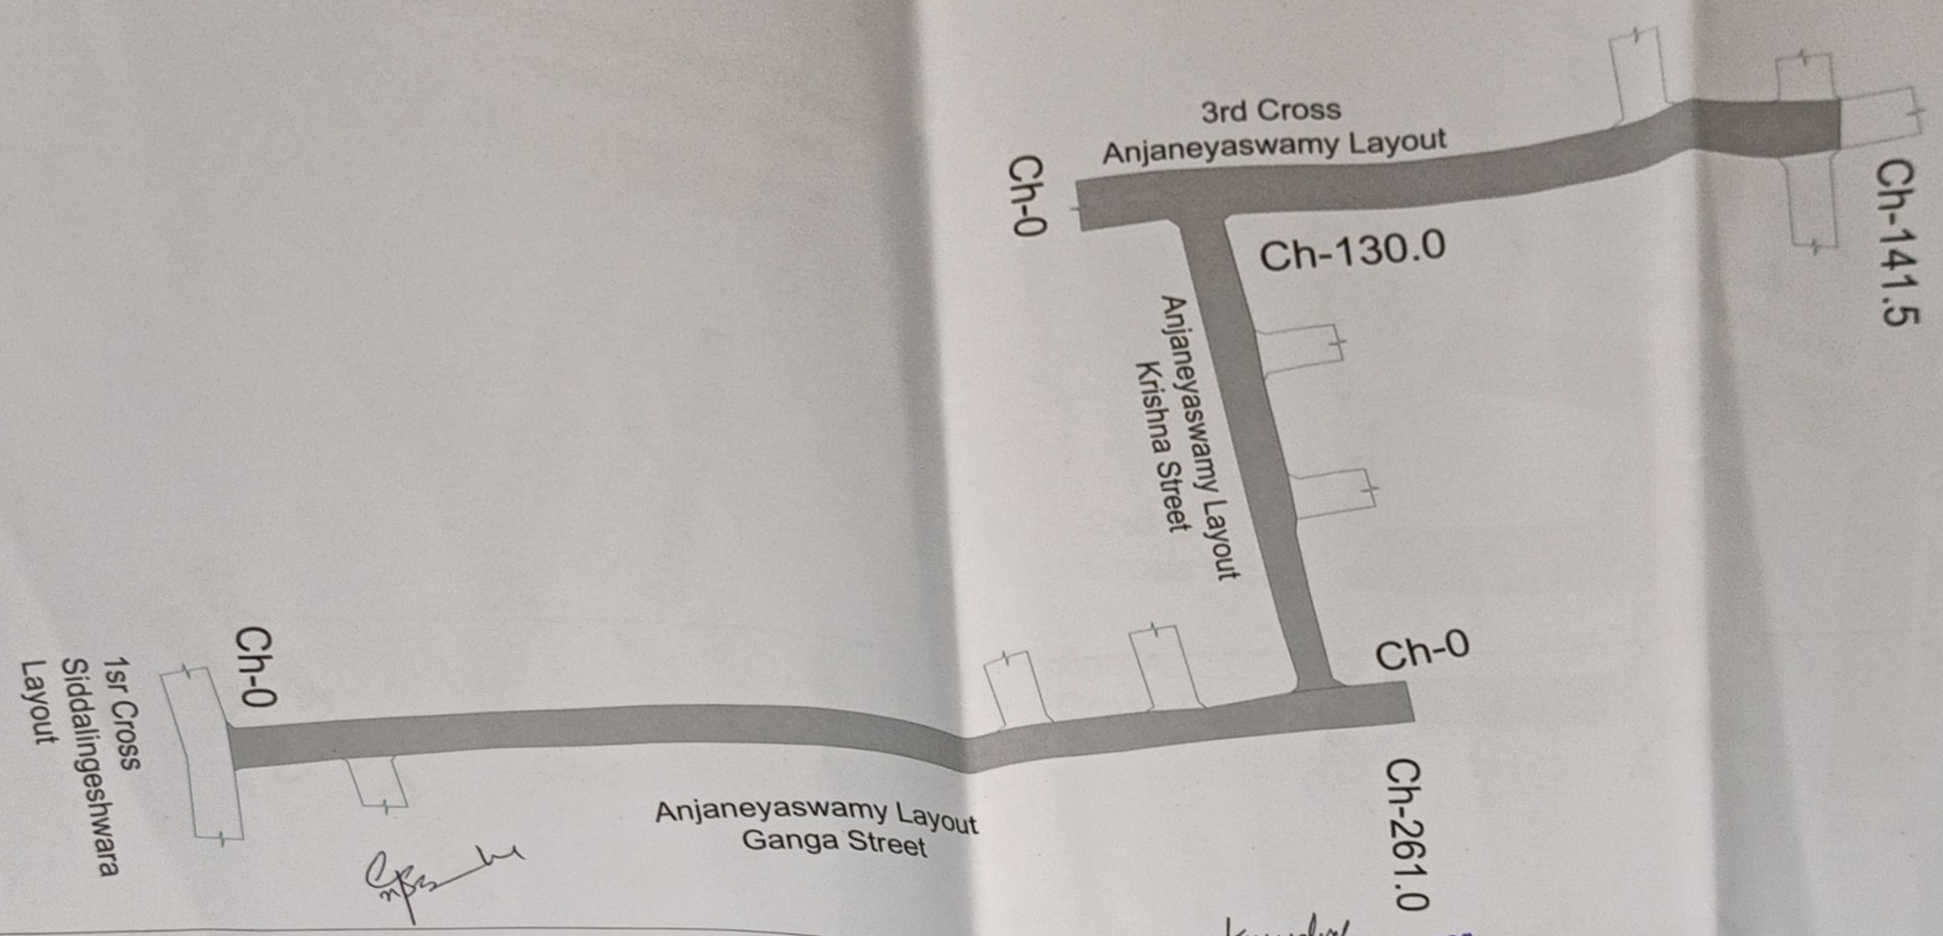

NOTE:-

1. ALL DIMENSION & LEVELS ARE Mts. UNLESS OTHERWISE MENTIONED.

DATE	No. OF PRINTS	PRINTS ISSUED TO	SIGN

DATE	REVISION	DESCRIPTIONS	SIGN

LEGEND:

ASPHALTED SURFACE

Asst. Executive Engineer
Project Division
Yelahanka Zone
BBMP, Bangalore - 92

CONSULTANT:


TEJUS CONSULTANTS
CONSULTING ENGINEERS AND DESIGNERS
No.45,Present BBMP No.1204/45,
Old No.1204,1st Main MRCR Layout ,Bangalore-560040
TEL:9611044110,9611192254
email: tejusconsultants@gmail.com

TITLE: AS BUILT DRAWING 1/1

Scanned by TapScanner

BRUHAT BANGALORE MAHANAGARA PALIKE

Improvements to widen portion of roads,construction of New drains UG Cable ducts and Footpath at Doddabommasandra main road and surroumding Roads in ward no 10

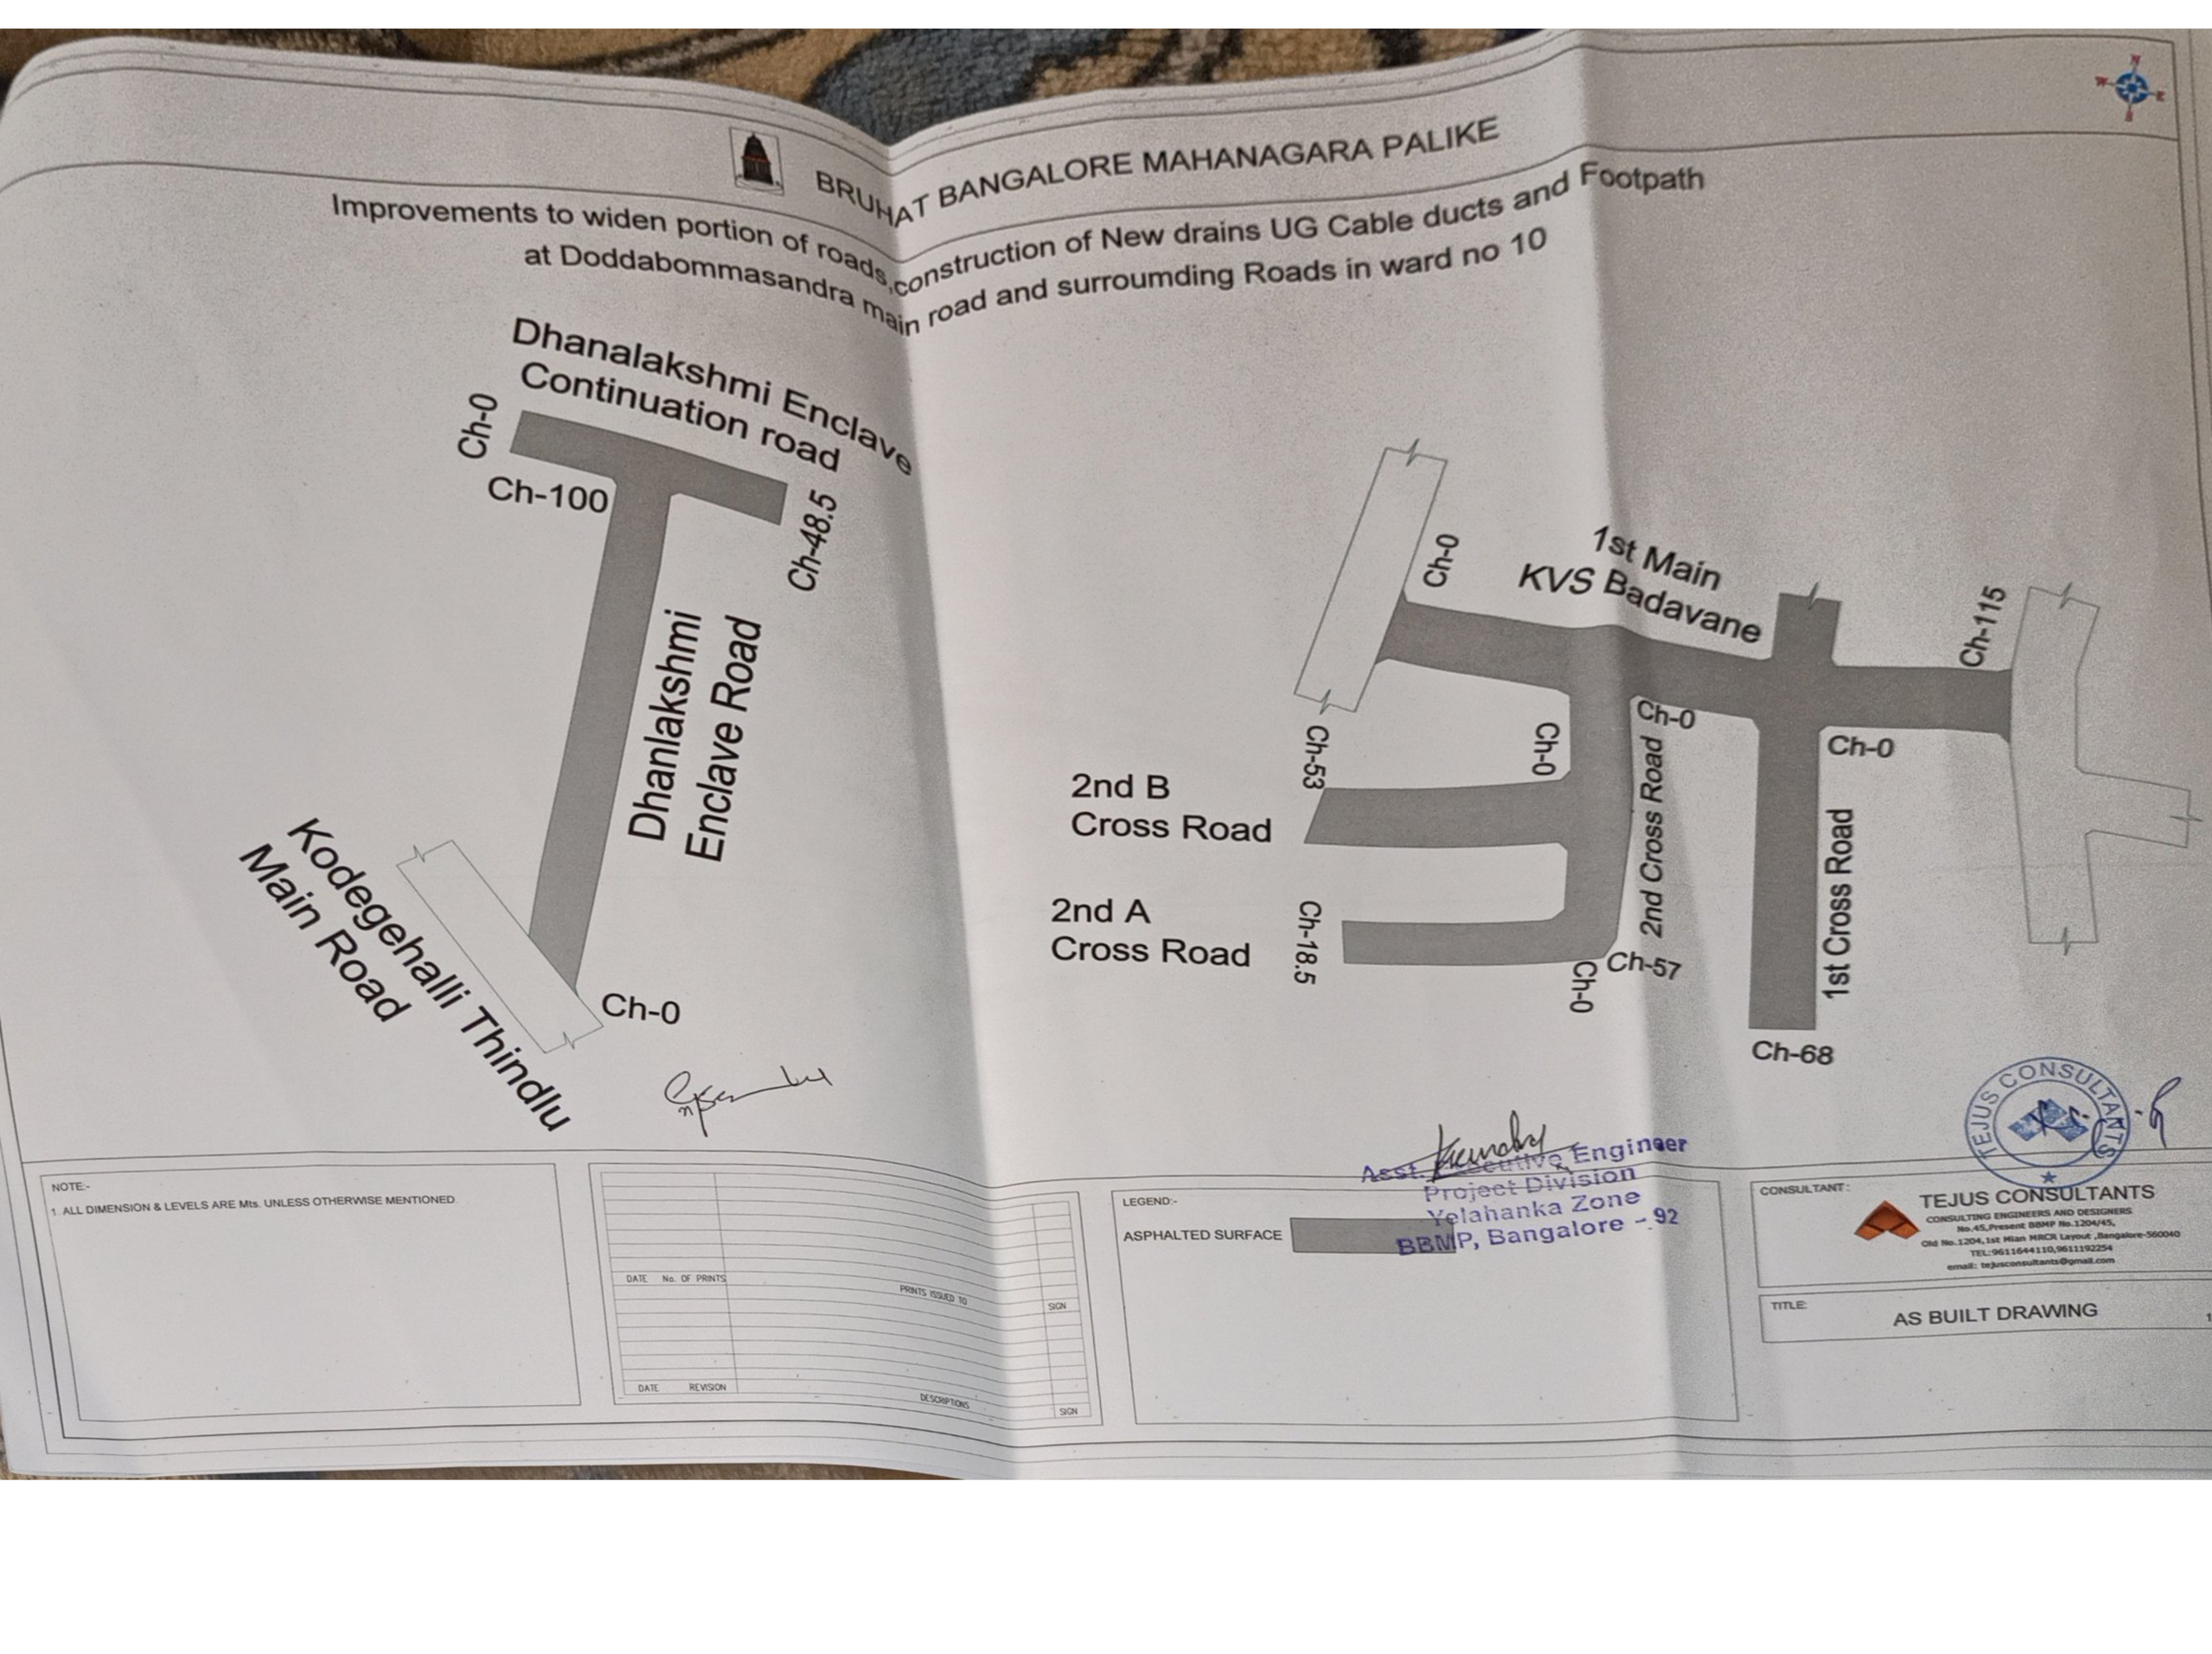

NOTE:-

1. ALL DIMENSION & LEVELS ARE Mts. UNLESS OTHERWISE MENTIONED.

DATE	No. OF PRINTS	PRINTS ISSUED TO	SIGN

DATE	REVISION	DESCRIPTIONS	SIGN

LEGEND:-

ASPHALTED SURFACE

Asst. Executive Engineer
Project Division
Yelahanka Zone
BBMP, Bangalore - 92

CONSULTANT:


TEJUS CONSULTANTS
CONSULTING ENGINEERS AND DESIGNERS
No.45,Present BBMP No.1204/45,
Old No.1204,1st Main MRCR Layout ,Bangalore-560040
TEL:9611644110,9611192254
email: tejusconsultants@gmail.com

TITLE: AS BUILT DRAWING 1/1

Scanned by TapScanner

BRUHAT BANGALORE MAHANAGARA PALIKE

Improvements to widen portion of roads,construction of New drains UG Cable ducts and Footpath at Doddabommasandra main road and surroumding Roads in ward no 10

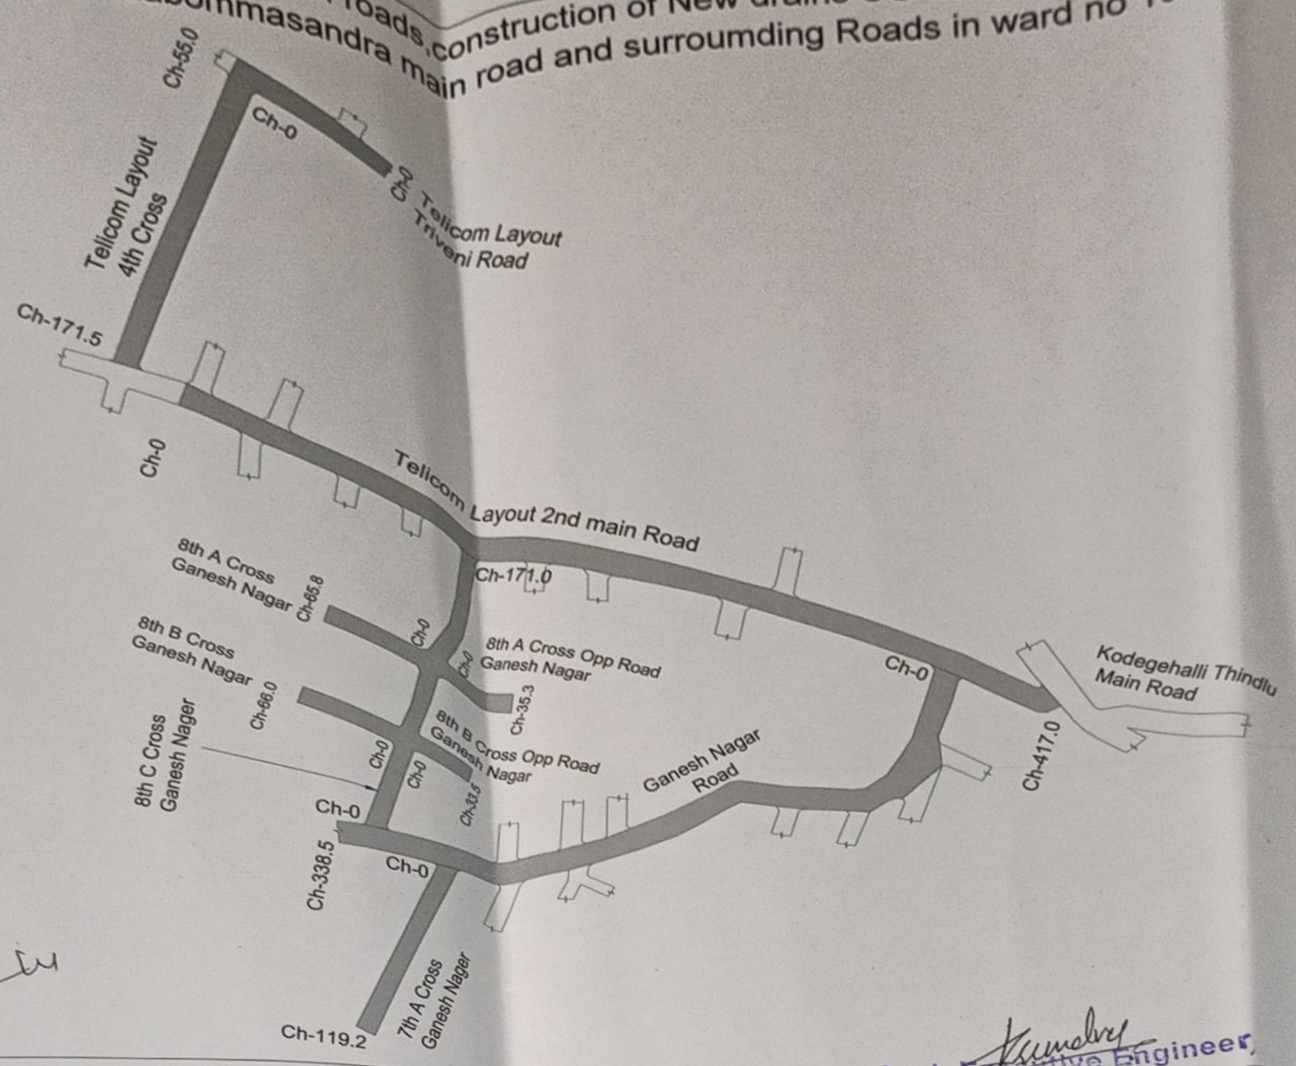

NOTE:-

1. ALL DIMENSION & LEVELS ARE Mts. UNLESS OTHERWISE MENTIONED.

DATE	No. OF PRINTS	PRINTS ISSUED TO	SIGN

DATE	REVISION	DESCRIPTIONS	SIGN

LEGEND:-

ASPHALTED SURFACE

Asst. Executive Engineer,
Project Division
Yelahanka Zone
BBMP, Bangalore - 92.

CONSULTANT :

TEJUS CONSULTANTS
CONSULTING ENGINEERS AND DESIGNERS
No.45,Present BBMP No.1204/45,
Old No.1204,1st Mian MRCR Layout ,Bangalore-560040
TEL:9611644110,9611192254
email: tejusconsultants@gmail.com

TITLE:

AS BUILT DRAWING 1/1

Scanned by TapScanner